

**LEGEND**

— 15.0	EXISTING SURFACE CONTOURS
— 15.0	DESIGN SURFACE CONTOURS
—	STAGE 1 BOUNDARY
---	EXISTING EASEMENT BOUNDARY
---	GOLF COURSE SITE BOUNDARY
---	TIP AREA BOUNDARY
---	PROPOSED BATTER
---	PROPOSED ROCK WALL
---	INDICATIVE AREA MAPPED ON EMR
(1)	STAGE 1 HOLE NUMBER (GREEN)
SW	EXISTING STORMWATER
W	EXISTING WATER MAIN
S	EXISTING SEWER
E	EXISTING ELECTRICAL
C	EXISTING TELSTRA
(oval)	PROPOSED GOLF COURSE FEATURES (TEES, FAIRWAYS, GREENS)
(oval)	EXISTING GOLF COURSE FEATURES (TEES, FAIRWAYS, GREENS)
(circle)	EXISTING TREE TO REMAIN
(circle)	EXISTING TREE TO BE REMOVED
(blue oval)	PROPOSED/EXISTING LAKES EXTENTS
(purple oval)	PROPOSED WETLAND EXTENTS

**EARTHWORKS DEPTH ANALYSIS LEGEND**

-5.0 to -4.5	(dark purple)
-4.5 to -4.0	(purple)
-4.0 to -3.5	(dark blue)
-3.5 to -3.0	(blue)
-3.0 to -2.5	(teal)
-2.5 to -2.0	(green-teal)
-2.0 to -1.5	(green)
-1.5 to -1.0	(light green)
-1.0 to -0.5	(yellow-green)
-0.5 to 0.0	(yellow)
0.0 to 0.5	(light yellow)
0.5 to 1.0	(pale yellow)
1.0 to 1.5	(yellow)
1.5 to 2.0	(light green)
2.0 to 2.5	(green)
2.5 to 3.0	(teal)
3.0 to 3.5	(blue-teal)
3.5 to 4.0	(blue)
4.0 to 4.5	(dark blue)
4.5 to 5.0	(purple)
5.0 to 5.5	(dark purple)

**NOTE:**  
ALL DESIGN/SETOUT INFORMATION SHOWN ON THIS DRAWING IS AVAILABLE IN DIGITAL FORMAT FROM THE OFFICE OF THE SUPERINTENDENT UPON REQUEST BY THE CONTRACTOR.

**WARNING : UNDERGROUND SERVICES**  
UNDERGROUND SERVICES EXIST IN THIS VICINITY. THE CONTRACTOR IS TO CONTACT THE RELEVANT AUTHORITIES TO CONFIRM EXACT LOCATION OF SERVICES ON SITE PRIOR TO ANY EXCAVATION OR CONSTRUCTION COMMENCING.

**NOTES:**

- Surface levels to be in accordance with the Approved Hydraulic Impact Assessment dated 17/02/2022 (amended in red 29/03/2022).
- Ecological requirements to be managed in accordance with the Approved Vegetation Management Plan, Approved Fauna Management Plan, Approved Tree Data Table, Approved Arborist Report, and Approved Tree Removal Plan.


**APPROVED PLAN**  
Brisbane City Council  
30/03/2022

APPROVED PLAN ONLY REFERS TO:

- Earthworks
- Stormwater
- Roadworks
- Traffic Functional Layout
- Traffic Signals
- Construction Management Plan
- WSUD Device(s)
- Signs and Linemarking

Other:

**AMENDED IN RED**  
29/03/2022

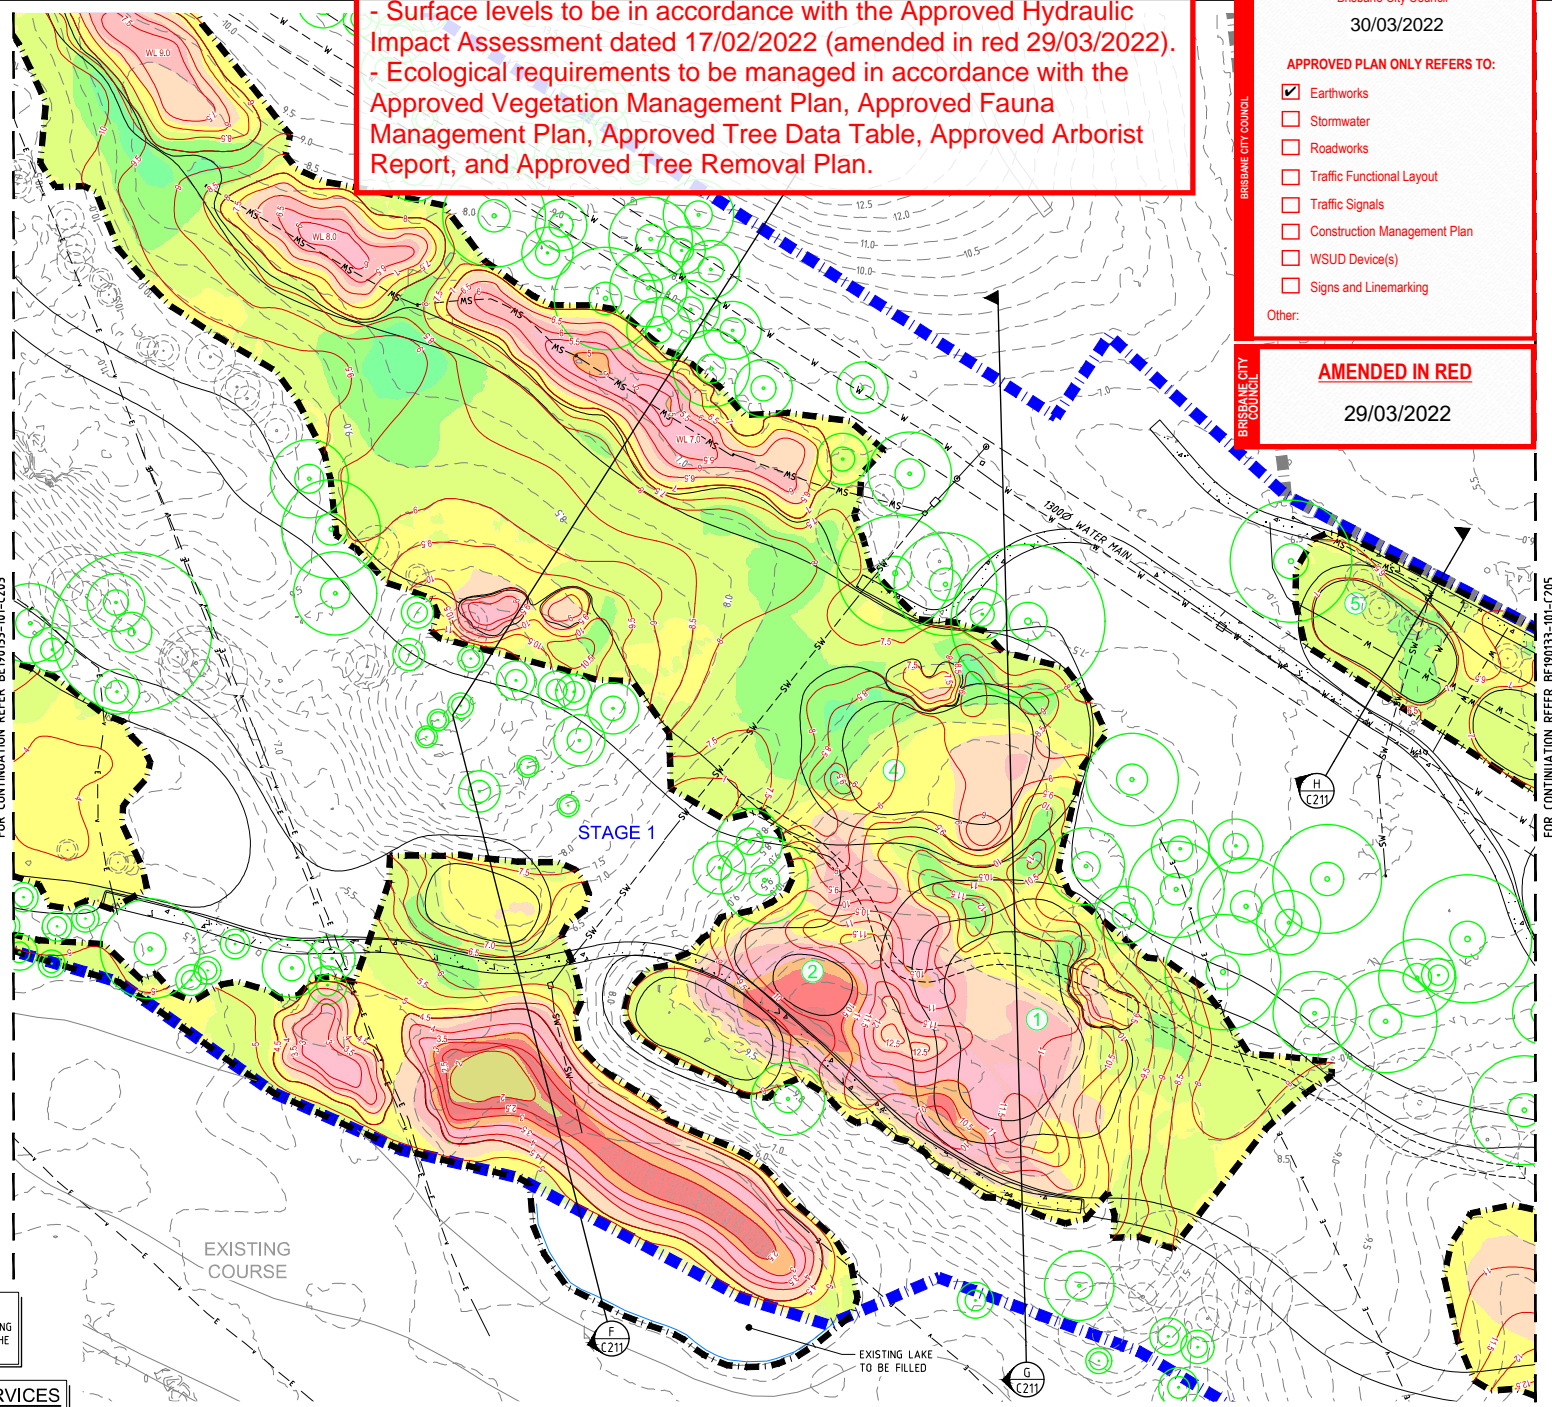

FOR CONTINUATION REFER BE190133-101-C205

**INDOOROOPILLY GOLF CLUB**

STAGE 1 WORKS

BCC DS  
Plans/Documents to BE RECEIVED  
11/03/2022  
APPLICATION REF  
A005911581

FOR  
INDOOROOPILLY GOLF CLUB

**A1** ORIGINAL SIZE BEFORE REDUCTION

B	REVISED ISSUE FOR APPROVAL	04-02-22
A	ISSUE FOR APPROVAL	21-12-21
VER:	DESCRIPTION	DATE

**COPYRIGHT (C)**  
This drawing is copyright and the property of Burchills Engineering Solutions. It must not be retained, copied or used without the authority of Burchills Engineering Solutions.  
**DISCLAIMER**  
This drawing and its contents are electronically generated, are confidential and may only be used for the purpose for which they were created.  
Burchills Engineering Solutions will not accept responsibility for any consequences arising from the use of the drawings for other than its intended purpose or where the drawing has been altered, amended or changed either manually or electronically by any third party.  
**NOTE**  
This is an uncontrolled document issued for information purposes only, unless the checked sections are signed or completed. Figure dimensions take precedence over scales. Do not scale reduced size drawings. Verify dimensions prior to commencing any on-site or off-site works or fabrication.

**BURCHILLS ENGINEERING SOLUTIONS**

Level 2, Connaught Centre  
26 Marine Parade, Southport QLD 4215  
PO Box 3766, Australia Fair, Southport QLD 4215  
Phone: +61 7 5509 6400  
Fax: +61 7 5509 6411  
Email: admin@burchills.com.au  
Cooko Burchills Engineering Pty Ltd  
ABN 76 166 942 365

PROJECT:  
**GOLF COURSE REDEVELOPMENT**

DRAWING TITLE:  
**EARTHWORKS LAYOUT PLAN - SHEET 4**

DEVEL. APPLIC. No.:	DATE:	04-02-2022
PROJECT LEADER:	DAVID WILLIAMS	
DESIGNER:	LIONEL LETCHER	
DRAFTSPERSON:	LIONEL LETCHER	
CHECKED:	DAVID WILLIAMS	
APPROVED FOR AND ON BEHALF OF BURCHILLS ENGINEERING SOLUTIONS ABN 76 166 942 365		
SCALE:	AS NOTED	DATUM: AHD
PROJECT No.:	BE190133-101	FULL SIZE: A1
DRAWING No.:	C204	
VERSION:	B	
RPEQ No.:	23464	

**BULK EARTHWORKS LAYOUT PLAN**  
SCALE 1 : 500 (FULL SIZE) (metres)

REVISED: 29/03/2022 BY: NSJ  
REFERENCE: 1:27/19/2021/STATE/BE190133 - Indoooropilly Golf Club - Major Renovation/Reloc. BE190133-101-C204