Surface flows must be captured and conveyed with a stormwater management system or catch drains contained within the site, and not be directed into adjoining sites or onto Meiers Road.

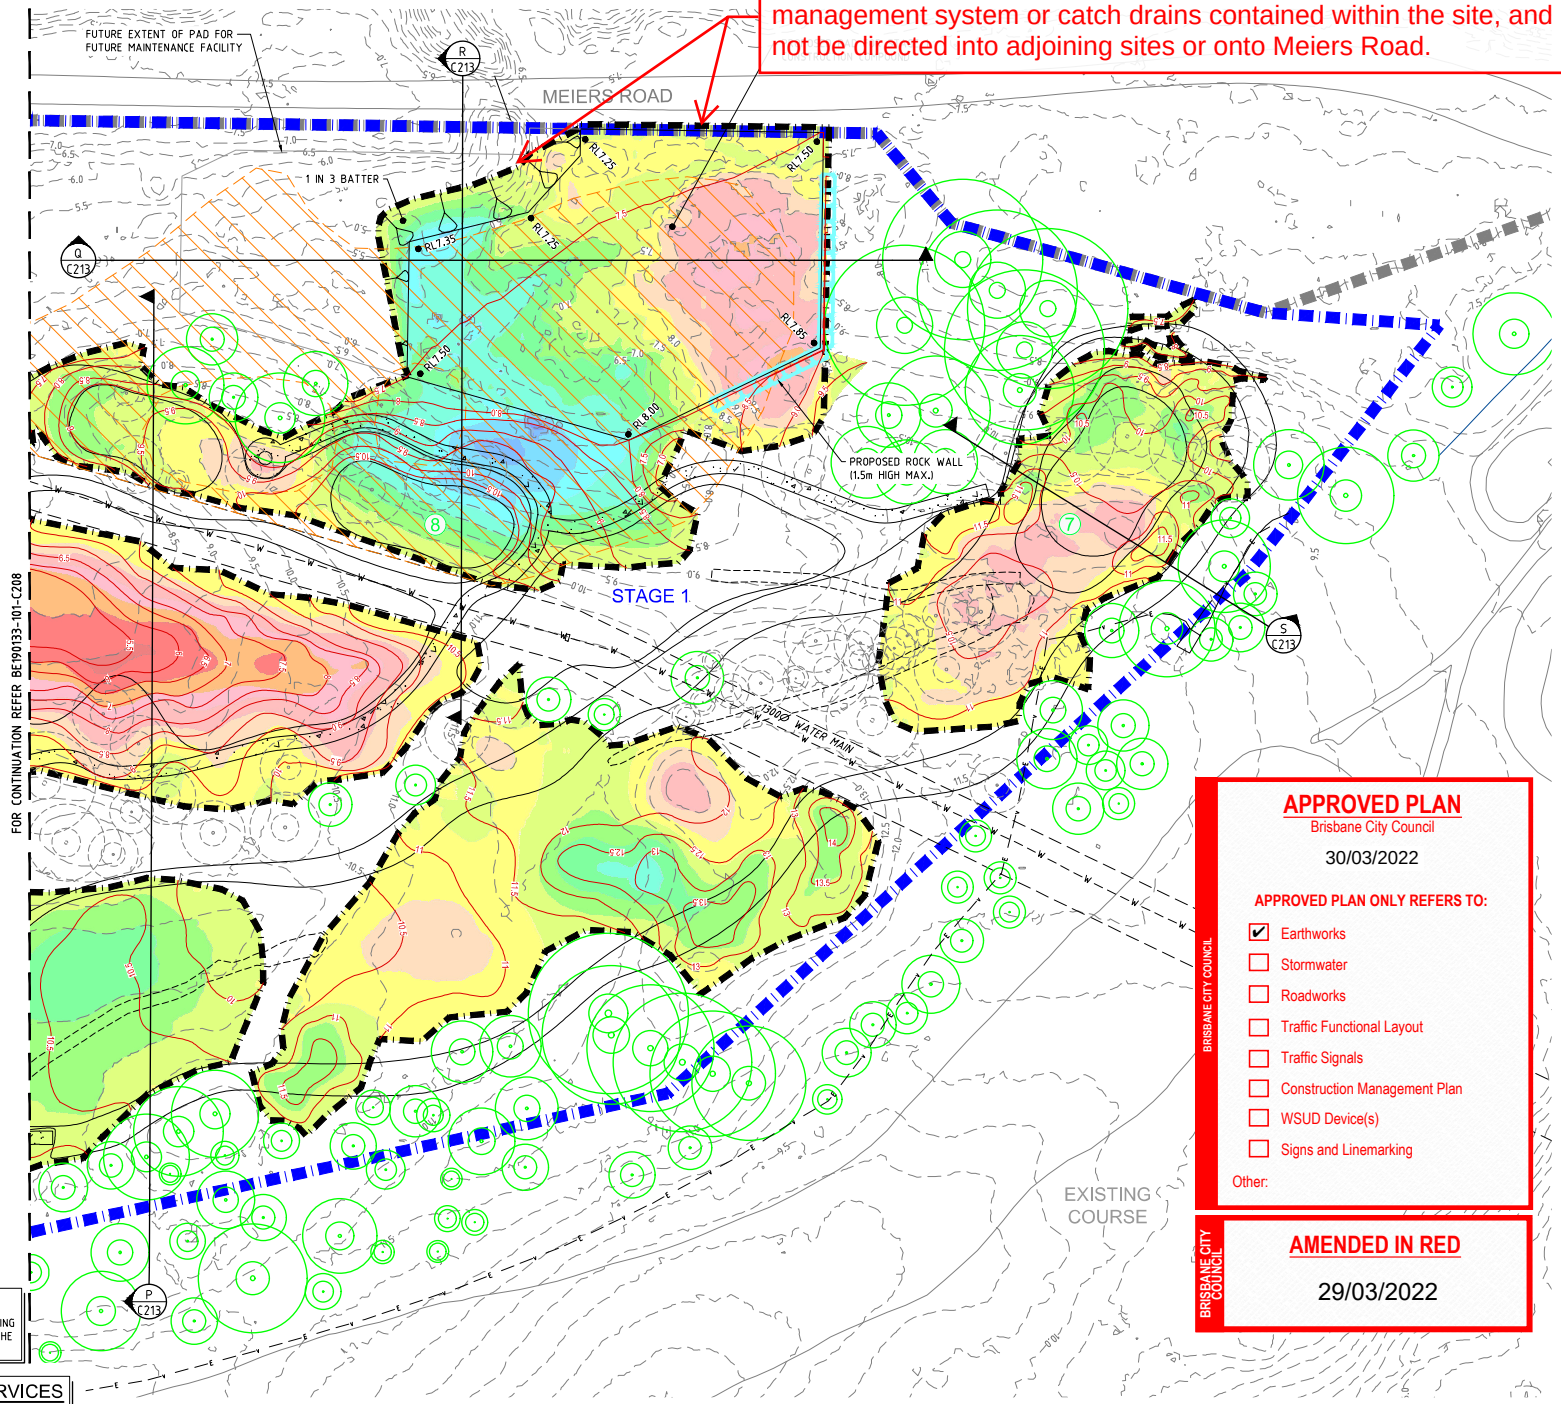

N

LEGEND

- EXISTING SURFACE CONTOURS
- DESIGN SURFACE CONTOURS
- STAGE 1 BOUNDARY
- EXISTING EASEMENT BOUNDARY
- GOLF COURSE SITE BOUNDARY
- TIP AREA BOUNDARY
- PROPOSED BATTER
- PROPOSED ROCK WALL
- INDICATIVE AREA MAPPED ON EMR
- STAGE 1 HOLE NUMBER (GREEN)
- EXISTING STORMWATER
- EXISTING WATER MAIN
- EXISTING SEWER
- EXISTING ELECTRICAL
- EXISTING TELSTRA
- PROPOSED GOLF COURSE FEATURES (TEES, FAIRWAYS, GREENS)
- EXISTING GOLF COURSE FEATURES (TEES, FAIRWAYS, GREENS)
- EXISTING TREE TO REMAIN
- EXISTING TREE TO BE REMOVED
- PROPOSED/EXISTING LAKES EXTENTS
- PROPOSED WETLAND EXTENTS

EARTHWORKS DEPTH ANALYSIS LEGEND		
-5.0	to	-4.5
-4.5	to	-4.0
-4.0	to	-3.5
-3.5	to	-3.0
-3.0	to	-2.5
-2.5	to	-2.0
-2.0	to	-1.5
-1.5	to	-1.0
-1.0	to	-0.5
-0.5	to	0.0
0.0	to	0.5
0.5	to	1.0
1.0	to	1.5
1.5	to	2.0
2.0	to	2.5
2.5	to	3.0
3.0	to	3.5
3.5	to	4.0
4.0	to	4.5
4.5	to	5.0
5.0	to	5.5

NOTE:
ALL DESIGN/SETOUT INFORMATION SHOWN ON THIS DRAWING IS AVAILABLE IN DIGITAL FORMAT FROM THE OFFICE OF THE SUPERINTENDENT UPON REQUEST BY THE CONTRACTOR.

WARNING : UNDERGROUND SERVICES
UNDERGROUND SERVICES EXIST IN THIS VICINITY. THE CONTRACTOR IS TO CONTACT THE RELEVANT AUTHORITIES TO CONFIRM EXACT LOCATION OF SERVICES ON SITE PRIOR TO ANY EXCAVATION OR CONSTRUCTION COMMENCING.

BULK EARTHWORKS LAYOUT PLAN

SCALE 5 0 5 10 15 20 25 (metres)
1 : 500 (FULL SIZE)

APPROVED PLAN
Brisbane City Council
30/03/2022

APPROVED PLAN ONLY REFERS TO:

- [x] Earthworks
- [ ] Stormwater
- [ ] Roadworks
- [ ] Traffic Functional Layout
- [ ] Traffic Signals
- [ ] Construction Management Plan
- [ ] WSUD Device(s)
- [ ] Signs and Linemarking

Other:

BRISBANE CITY COUNCIL

BRISBANE CITY COUNCIL
AMENDED IN RED
29/03/2022

INDOOROOPILLY GOLF CLUB

STAGE 1 WORKS

BCC DS
Plans/Documents RECEIVED
11/03/2022
APPLICATION REF
A005911581

FOR

INDOOROOPILLY GOLF CLUB

A1 ORIGINAL SIZE BEFORE REDUCTION

VER.	DESCRIPTION	DATE
B	REVISED ISSUE FOR APPROVAL	04-02-22
A	ISSUE FOR APPROVAL	21-12-21

COPYRIGHT ©
This drawing is copyright and the property of Burchills Engineering Solutions. It must not be retained, copied or used without the authority of Burchills Engineering Solutions.

DISCLAIMER
This drawing and its contents are electronically generated, are confidential and may only be used for the purpose for which they were intended.
Burchills Engineering Solutions will not accept responsibility for any consequences arising from the use of the drawing for other than its intended purpose or where the drawing has been altered, amended or changed either manually or electronically by any third party.

NOTE
This is an uncontrolled document issued for information purposes only, unless the checked sections are signed or completed.
Figured dimensions take precedence over scale. Do not scale reduced size drawings. Verify dimensions prior to commencing any on-site or off-site works or fabrication.

BURCHILLS ENGINEERING SOLUTIONS
Level 2, Connaught Centre
26 Marine Parade, Southport QLD 4215
PO Box 3766, Australia Fair, Southport QLD 4215
Phone: +61 7 5509 6400
Fax: +61 7 5509 6411
Email: admin@burchills.com.au
Coote Burchills Engineering Pty Ltd
ABN 76 166 942 365

PROJECT:

GOLF COURSE REDEVELOPMENT

DRAWING TITLE :

EARTHWORKS LAYOUT PLAN - SHEET 9

DEVEL. APPLIC. No. :	DATE : 04-02-2022
PROJECT LEADER :	DAVID WILLIAMS
DESIGNER :	LIONEL LETCHER
DRAFTSPERSON :	LIONEL LETCHER
CHECKED :	DAVID WILLIAMS

APPROVED FOR AND ON BEHALF OF BURCHILLS ENGINEERING SOLUTIONS ABN 76 166 942 365
RPEQ No. : 23404

SCALE : AS NOTED	DATUM : AHD	FULL SIZE : A1
PROJECT No.: BE190133-101	DRAWING No. : C209	VERSION: B

FILENAME: L:\Projects\2019\BE190133_Indooroopilly Golf Club Master Plan\Civil\Acad\BE190133-101-C201 - C218.dwg
PLOTTED: 25.02.2022 at 16:23